


NOTE :

1. ALL OPENINGS & SPACE NUMBERS ON THIS PART PLAN SHALL BE PREFIXED WITH THE NUMBER & LETTER: 22A.
2. FOR DETAILED 1/4" PLANS OF THIS AREA SEE DWGS. A-874, A-876, A-877, A-878, A-879, & 880.
3. FOR CORRECT LAYOUT OF HORIZONTAL RUNS OF WASTE & LINEN CHUTES SEE HVAC DWGS.
4. IN ALL AREAS OF ALL FLOORS WHERE WASTE & LINEN CHUTES ARE SHOWN CHARGE OVER THE PHYSICAL LOCATION OF HORIZONTAL RUNS SHALL BE DISREGARDED. THE ROUTING OF ALL WASTE & LINEN CHUTES SHALL BE AS SHOWN ON HVAC DWGS. 181-H-764 THRU H-775

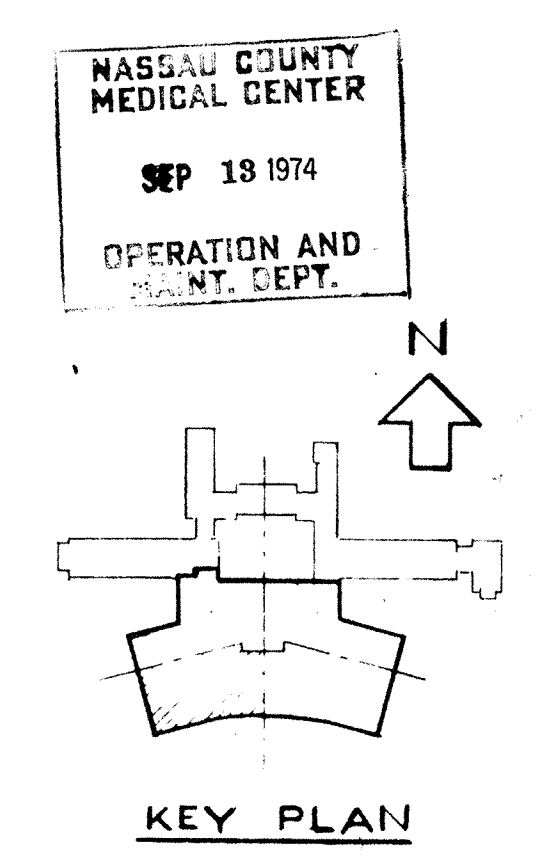

THIS DRAWING INDICATES
WORK AS BUILT
Continued to See 9.

	THE OFFICE OF MAX O. URBAN ARCHITECTS 642 FIFTH AVENUE, NEW YORK, N.Y. 10019	MEADOWBROOK HOSPITAL EAST MEADOW, TOWN OF HEMPSTADT, NASSAU COUNTY, NEW YORK
	FRATOLI - BLUM - YESSELMAN STRUCTURAL ENGINEERS, NEW YORK, N.Y. FRANK J. SULLIVAN & ASSOCIATES MECHANICAL ENGINEERS, NEW YORK, N.Y. V. L. FALOTTO & ASSOCIATES CONSULTING ENGINEERING, BROOKLYN, N.Y.	DYNAMIC CARE BUILDING 2ND FLOOR PLAN AREA A
	SASAKI, DAWSON, DEMAY ASSOCIATES, INC. LANDSCAPE ARCHITECTURE, WATERTOWN, MASS.	NASSAU COUNTY DWG. NO. _____ CONTRACT NO. _____ A-716